


1 2ND FLOOR SMOKE DETECTOR PLAN - SOUTH  
SCALE: 3/16" = 1'-0"

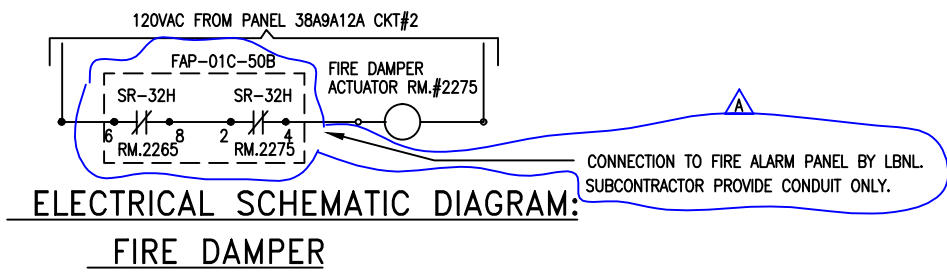

### LEGEND & ABBREVIATIONS

- (E), ——— EXISTING TO REMAIN UON  
(ER) ~~-----~~ EXISTING TO BE REMOVED AND REPLACED WITH NEW AS SHOWN  
NEW AS SHOWN, SEE APPROPRIATE SYMBOL BELOW
- ① SHEETNOTE IDENTIFICATION TAG
- Ⓢ WALL MOUNTED SPEAKER.
- POWER PANEL.
- Ⓛ EMERGENCY LIGHT PAK
- Ⓢ SMOKE DETECTOR  
P = PHOTOELECTRIC, I = IONIZATION  
# = DETECTOR NUMBER
- Ⓛ LIGHTS AT 6' 11"
- Ⓛ 2' X 4' FLUORESCENT FIXTURES WITH (2) T8 LAMPS  
A = LIGHT CONTROLLED BY SWITCH "A"
- Ⓛ 1' X 4' FLUORESCENT FIXTURES WITH (2) T8 LAMPS
- Ⓛ BREAK GLASS SWITCH
- EPO EMERGENCY POWER OFF

### GENERAL NOTES:

1. PRIOR TO CONSTRUCTION, FIELD TO VERIFY EXISTING CONDITIONS, ELEVATIONS, DIMENSIONS, EQUIPMENT RATINGS, AND INFORM CONSTRUCTION Supt/ ENGINEER OF CONFLICTS, INTERFERENCES & UNEXPECTED CONDITIONS.
2. TAG & LABEL ALL ELECTRICAL EQUIPMENT & DEVICES. UPDATE PANEL SCHEDULES.
3. FIELD TO SUBMIT MARKED UP PRINTS AFTER INSTALLATIONS COMPLETE FOR "AS-BUILTS".
4. COORDINATE ALL WORK WITH CLIENT.
5. FILL ALL THRU-PENETRATIONS W/ U.L. APPROVED FIRE SEALANT / ASSEMBLY.

### SHEET NOTES:

- ① RELOCATE EMERGENCY LIGHT AS SHOWN EXTEND CONDUIT & WIRING AS REQUIRED.
- ② REWIRE EXISTING SMOKE DETECTORS IN RM.#2275 & CONNECT TO ZONE 70. EXTEND CONDUIT & WIRING AS REQUIRED.
- ③ REWIRE EXISTING SMOKE DETECTORS IN RM.#2265 & CONNECT TO ZONE 69. EXTEND CONDUIT & WIRING AS REQUIRED.
- ④ RELOCATE EXISTING LIGHTING FIXTURE AS SHOWN. EXTEND CONDUIT & WIRING AS REQUIRED.
- ⑤ PRIOR TO RELOCATING VERIFY EXISTING LIGHTING SWITCHES THAT SERVE THE EXISTING LIGHTING FIXTURE IN RM.#2275, RELOCATE AS SHOWN, REWIRE AS NECESSARY. EXTEND CONDUIT & WIRING AS REQUIRED.
- ⑥ RELOCATE EXISTING LIGHTING SWITCHES TO NEW DOOR LOCATION AS SHOWN, REWIRE AS NECESSARY. EXTEND CONDUIT & WIRING AS REQUIRED.
- ⑦ RELOCATE EXISTING EXIT SIGN, BREAK GLASS SWITCH & DOOR CONTROL ACCESS DEVICES TO NEW DOOR LOCATION. REWIRE AS NECESSARY. EXTEND CONDUIT & WIRING AS REQUIRED.
- ⑧ FIRE SMOKE DAMPER, SEE MECHANICAL DWG. 4B50BM096 FOR EXACT LOCATION.
- ⑨ REMOVE CONDUITS AS SHOWN ON THE DWG. AFTER MODIFICATION OF FIRE ALARM SYSTEM (EPO, ZONE SEPARATION FOR RMS.2265 & 2275, AHU & DAMPERS SHUTDOWN) IS COMPLETED.
- ⑩ IN EXISTING PANEL E38A9A12A INSTALL NEW 1P, 20A BREAKER IN SPACE #2 INSTALL 2#12 & 1#12G IN 3/4"C TO NEW FIRE DAMPER.

<div>PROFESSIONAL SEAL (IF REVISION, APPLIES ONLY TO REVISED WORK)</div>	<div>TITLE II CONSTRUCTION A 08/13/01</div>								<div>50B DEMISING WALL RMS 2265 &amp; 2275 ELECTRICAL LTG &amp; FA LAYOUT</div>	<div>ESNT</div>		<div>DRAWN BY TK</div>		<div>DATE 08/10/01</div>				
			<div>CHECKED BY MG</div>		<div>08/13/01</div>													
			<div>APPROVED BY MG</div>		<div>08/13/01</div>													
			<div>CAD FILE PATH 00012662</div>															
			<div>SCALE As Noted</div>															
			<div>DRAWING NO. 4B50BE229A</div>		<div>SHEET E2</div>													
			<div>PROJECT NO. FX1051</div>															
			<div>2 OF 2</div>															
		</																